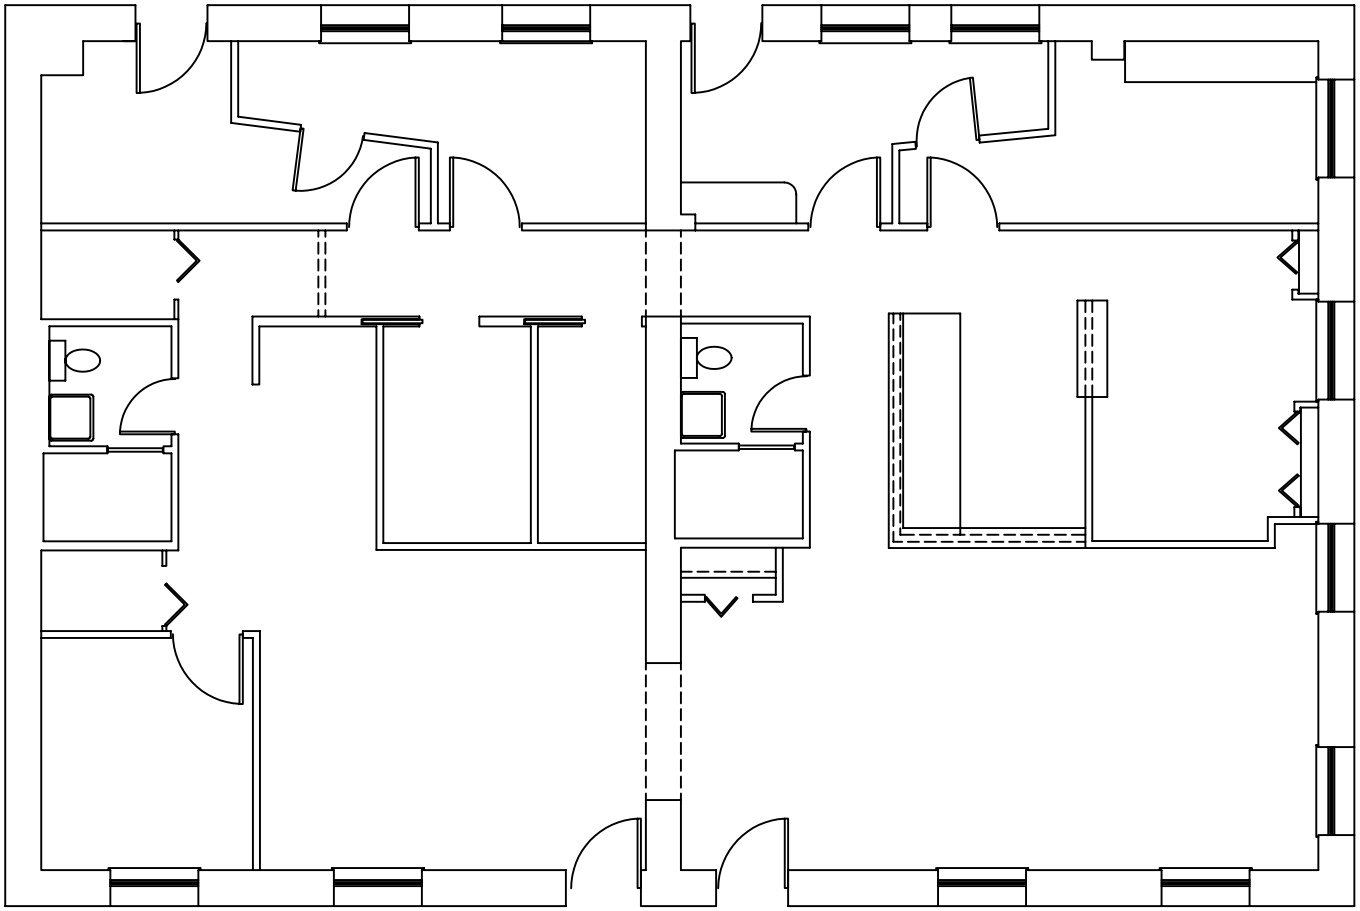

NANCY FOREMAN DESIGN, INC. T/A NFD DOES NOT WARRANT THE ACCURACY OF ANY DIMENSIONS SET FORTH HERE ON. CONTRACTOR IS RESPONSIBLE FOR VERIFYING ALL SITE CONDITIONS TO INCLUDE FIELD DIMENSIONS WHERE APPLICABLE. SHOULD THERE BE ANY DISCREPANCIES WITH THIS CONSTRUCTION DRAWING PACKAGE, NFD SHOULD BE NOTIFIED IMMEDIATELY FOR RESPONSE. IF THE CONTRACTOR, SUBCTS TO MAKE ANY CHANGES ON HIS OWN WITHOUT NOTIFYING NFD, HE IS RESPONSIBLE FOR SAME. NFD DOES NOT PROVIDE ARCHITECTURAL, STRUCTURAL, ENGINEERING OR MECHANICAL SERVICES. IF SUCH SERVICES ARE REQUIRED BY THIS DRAWING PACKAGE, A LICENSED PROFESSIONAL MUST BE RETAINED. NFD PREPARED THIS DRAWING PACKAGE AS A PRACTICAL SOLUTION TO INTERIOR DESIGN PROBLEMS. IT IS NOT INTENDED FOR ARCHITECTURAL, ENGINEERING OR CONSTRUCTION USE. ANY CEILING, ELECTRICAL, KITCHEN, BATHROOM OR LIKE PLAN OR SPECIFICATION IS PREPARED TO SHOW ONLY LOCATION OF OUTLETS, FIXTURES, VENTS, ETC. AND THE TYPE OF FIXTURE AND EQUIPMENT. THIS DRAWING PACKAGE IS THE PROPERTY OF NFD. UNAUTHORIZED USE OF THESE DOCUMENTS IS PROHIBITED.

AVAILABLE SPACE

SCIENCE PARK - UNITS M8A & M8B
6201 GREENBELT ROAD
COLLEGE PARK, MD 20740

AS-BUILT PLAN
2,006 SQUARE FEET

		REVISIONS
DATE:	27 JULY 06	
SCALE:	N.T.S.	
JOB NO:	CR097	
DESIGN BY:	C.K.H.	
DRAWN BY:	C.K.H.	
CHECKED BY:	C.K.H.	

NFD
NANCY FOREMAN DESIGN, INC.
BALTIMORE RICHMOND
16 GREENMEADOW DRIVE
TIMONIUM, MARYLAND 21093
410/561-0561 804/747-9559